# IRREGULAR SURVEY OF

Note.—Record Surveyor's Certificate in margin lines, numbering each survey from 1 up, on each section.

Acres, Blackmar & Co., Makers, Burlington, Iowa.

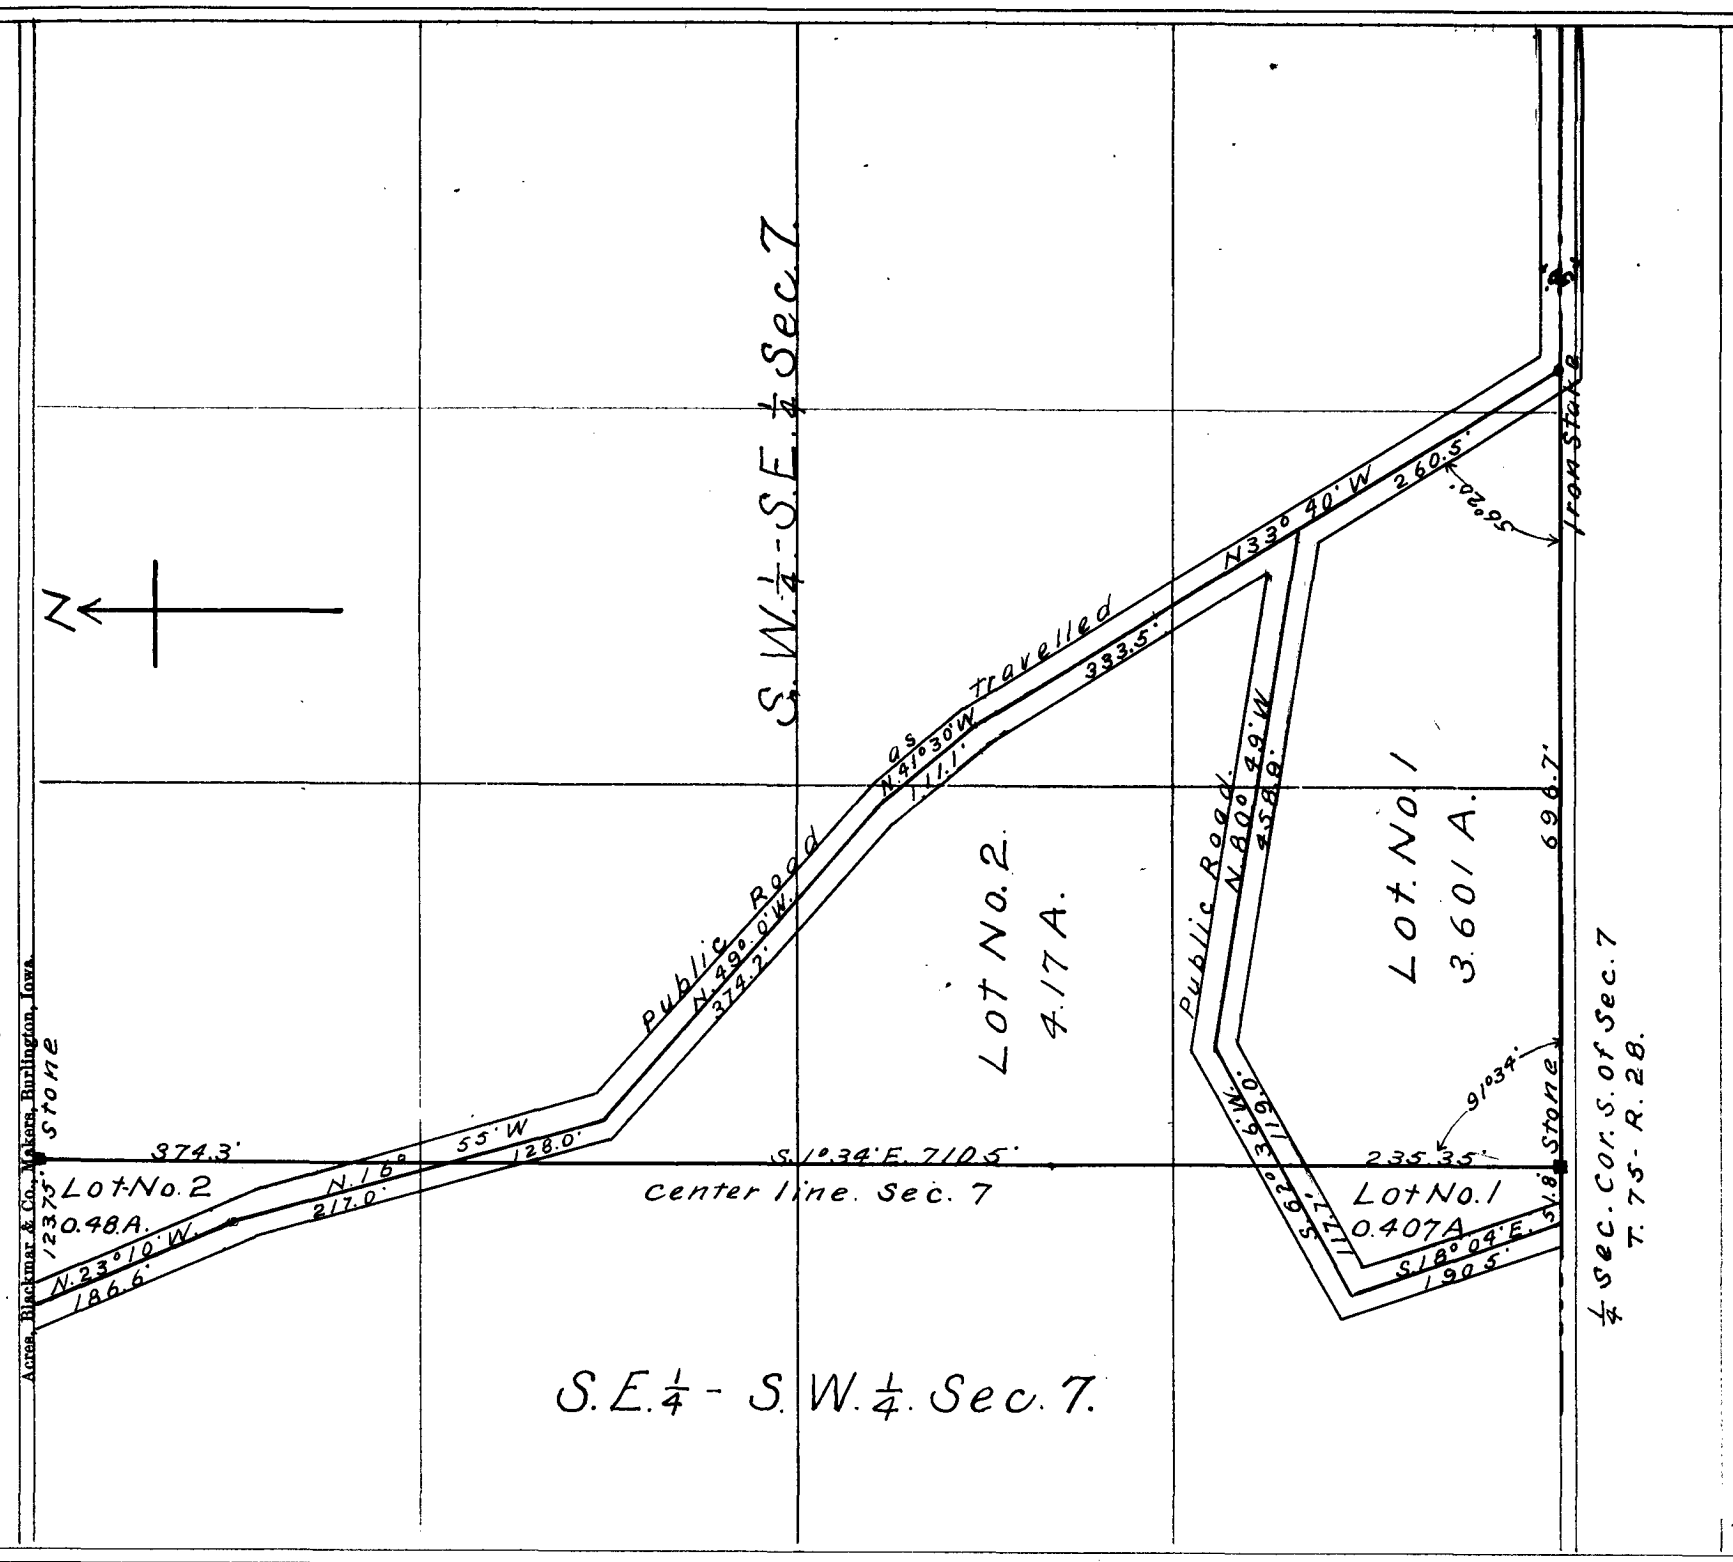


I hereby certify that the above is a correct plat of a survey made by me Sept. 29. 1917, at the request of D. M. Gentry. Scale 1" = 150'. I certify the above plat shows the courses and distances in feet and tenths, of the parts of the S.W.¼ S.E.¼ and the S.E.¼ S.W.¼ Sec. 7 Twn. 7 S. R. 28. as described by lot numbers and their contents.

E. B. Hiatt.
County Engineer.

Filed for record this 4th day of January A.D. 1919 at 3:10 o'clock P.M.
Nettie E. Winship Recorder
Doc # 16

67